


LOCATION MAP (NO SCALE)




LEGEND



- Soil Profile Trench
- Monitoring Well
- Percolation Test
- Clean Out
- Check Valve
- Air Release Valve
- Gravity Line
- Pressure Line

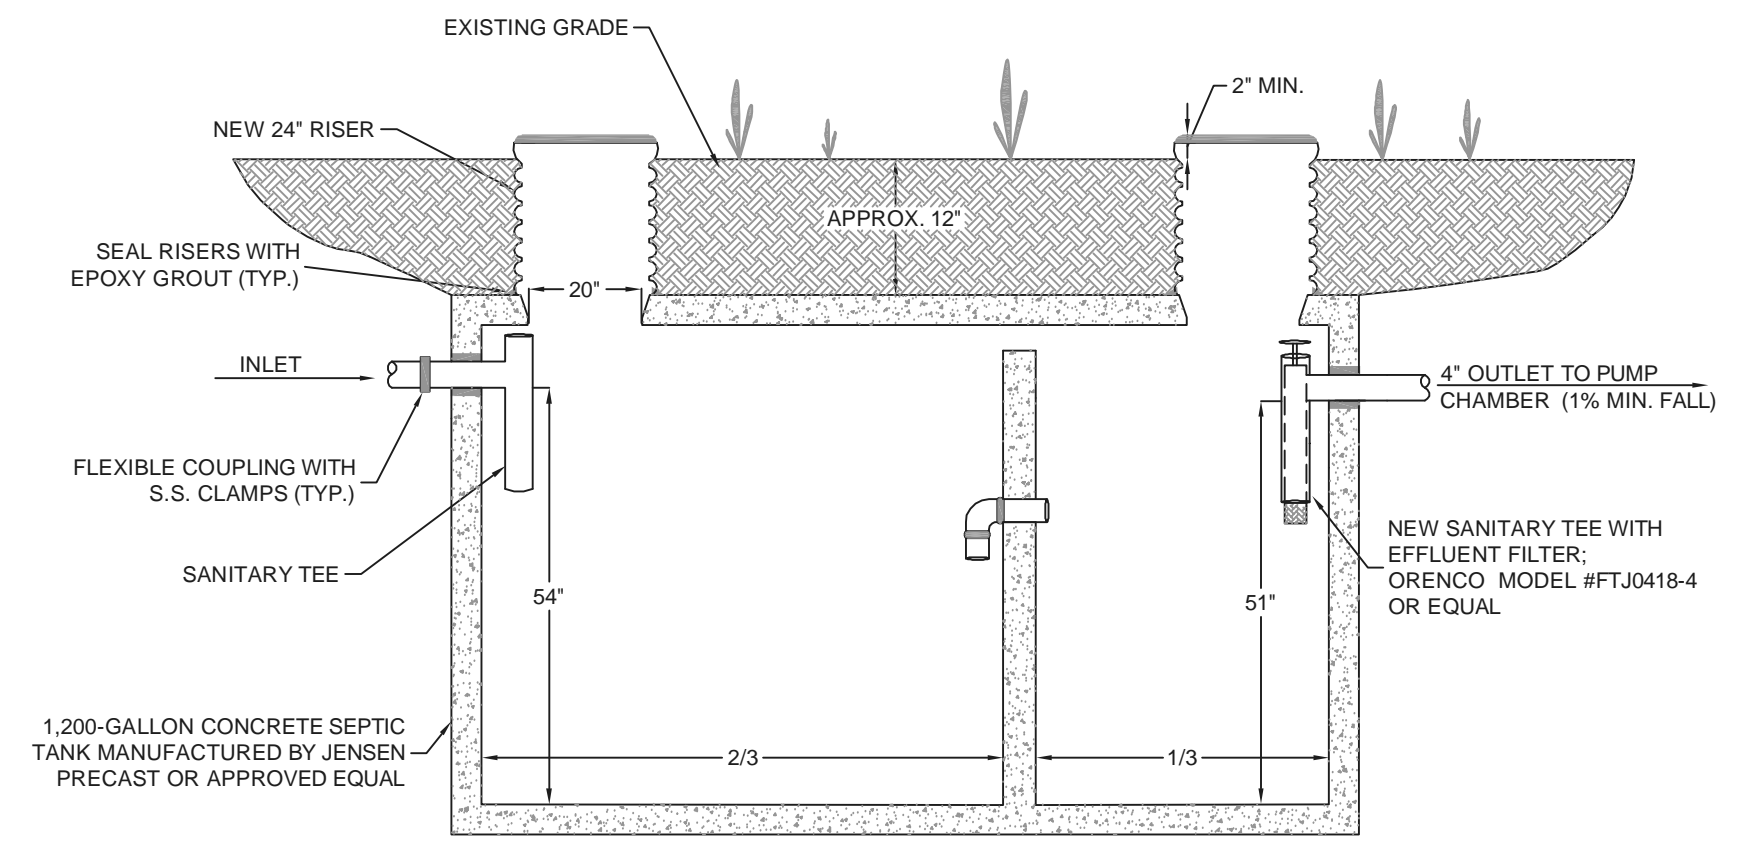



1,200-GALLON SEPTIC TANK 1

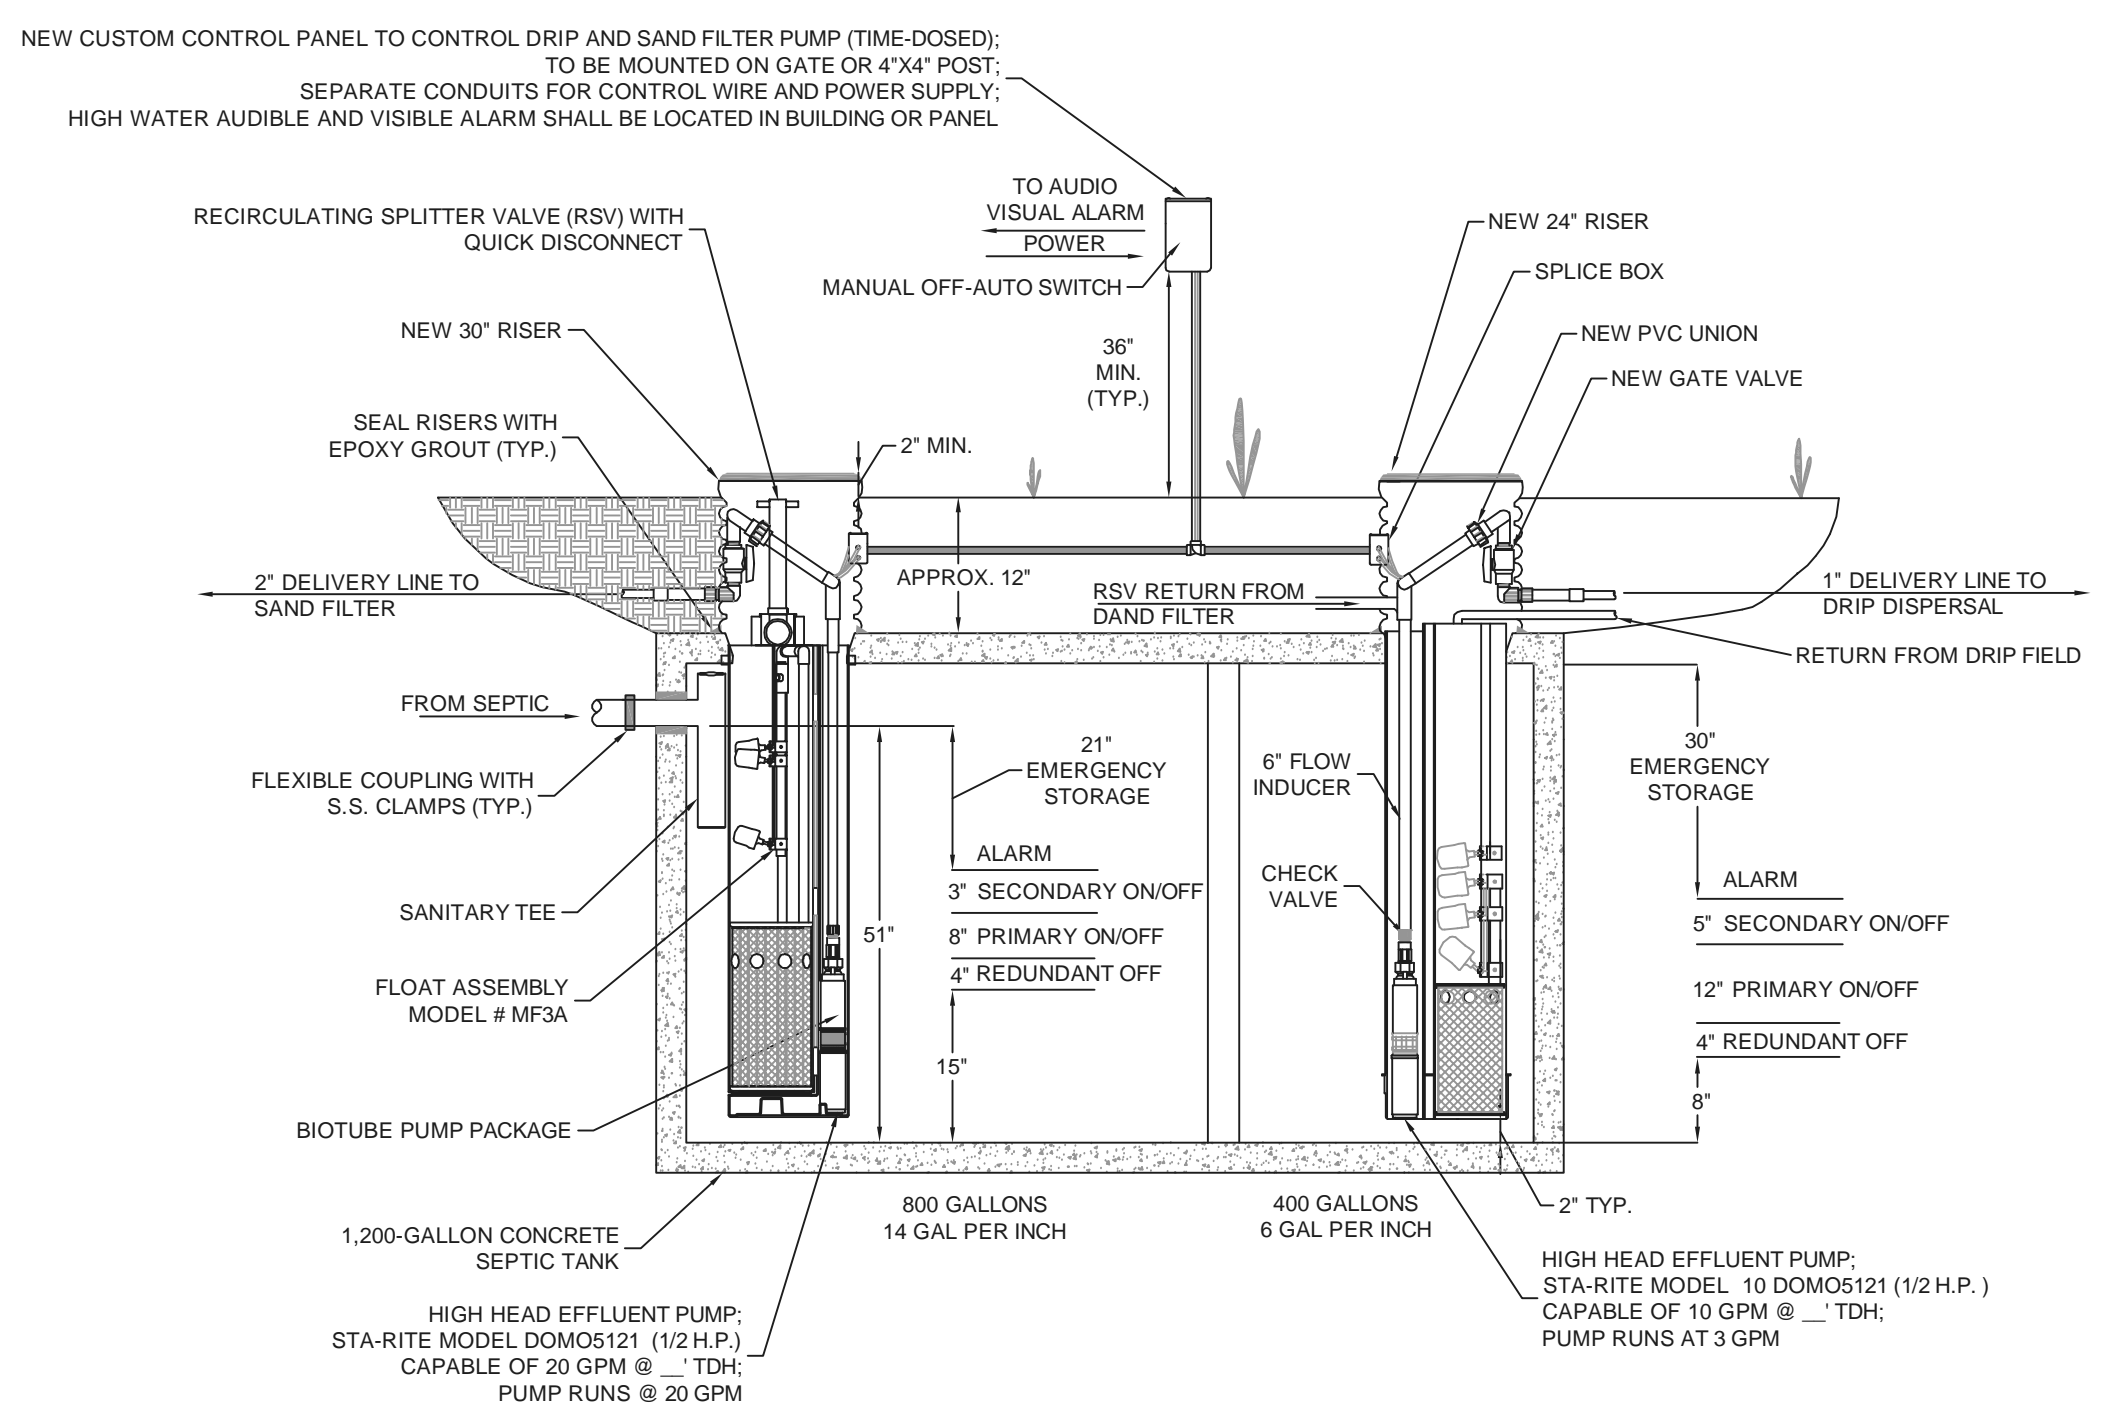


1,200-GALLON PUMP CHAMBER 2

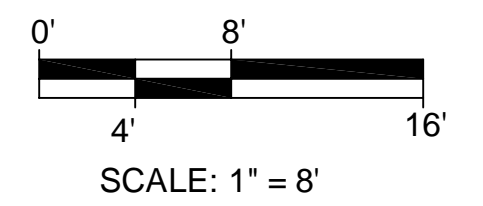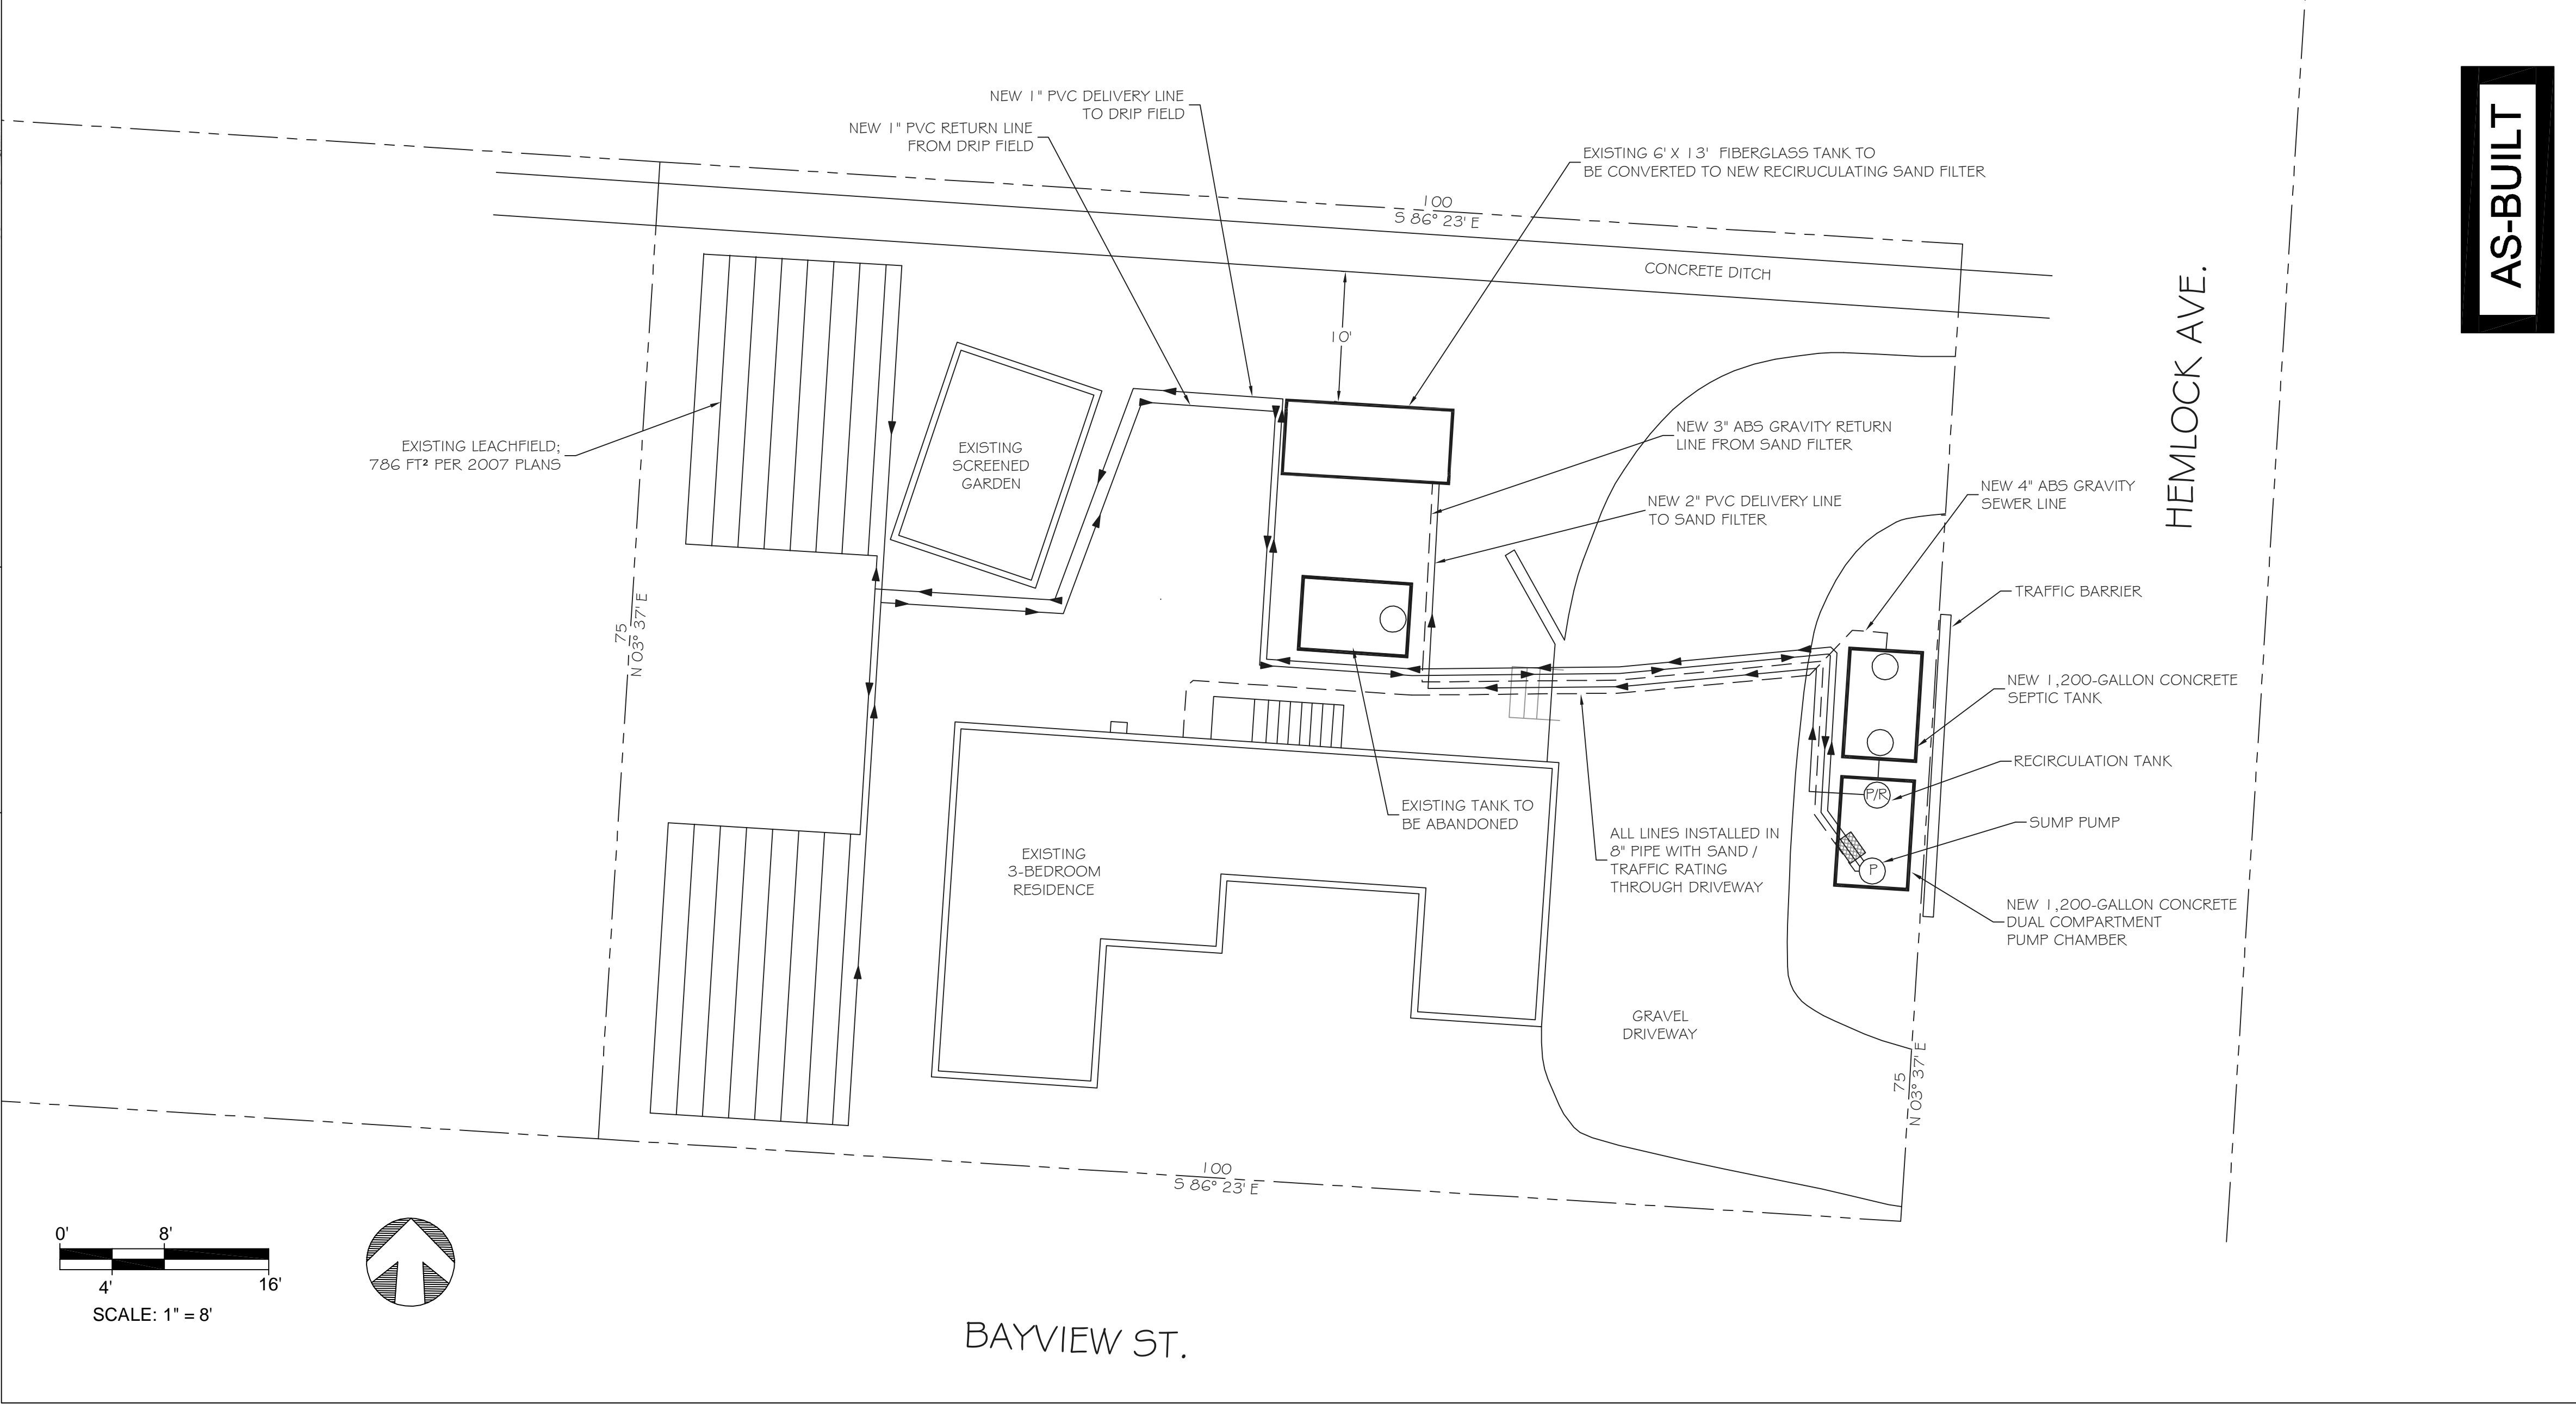

SCALE: 1" = 8'

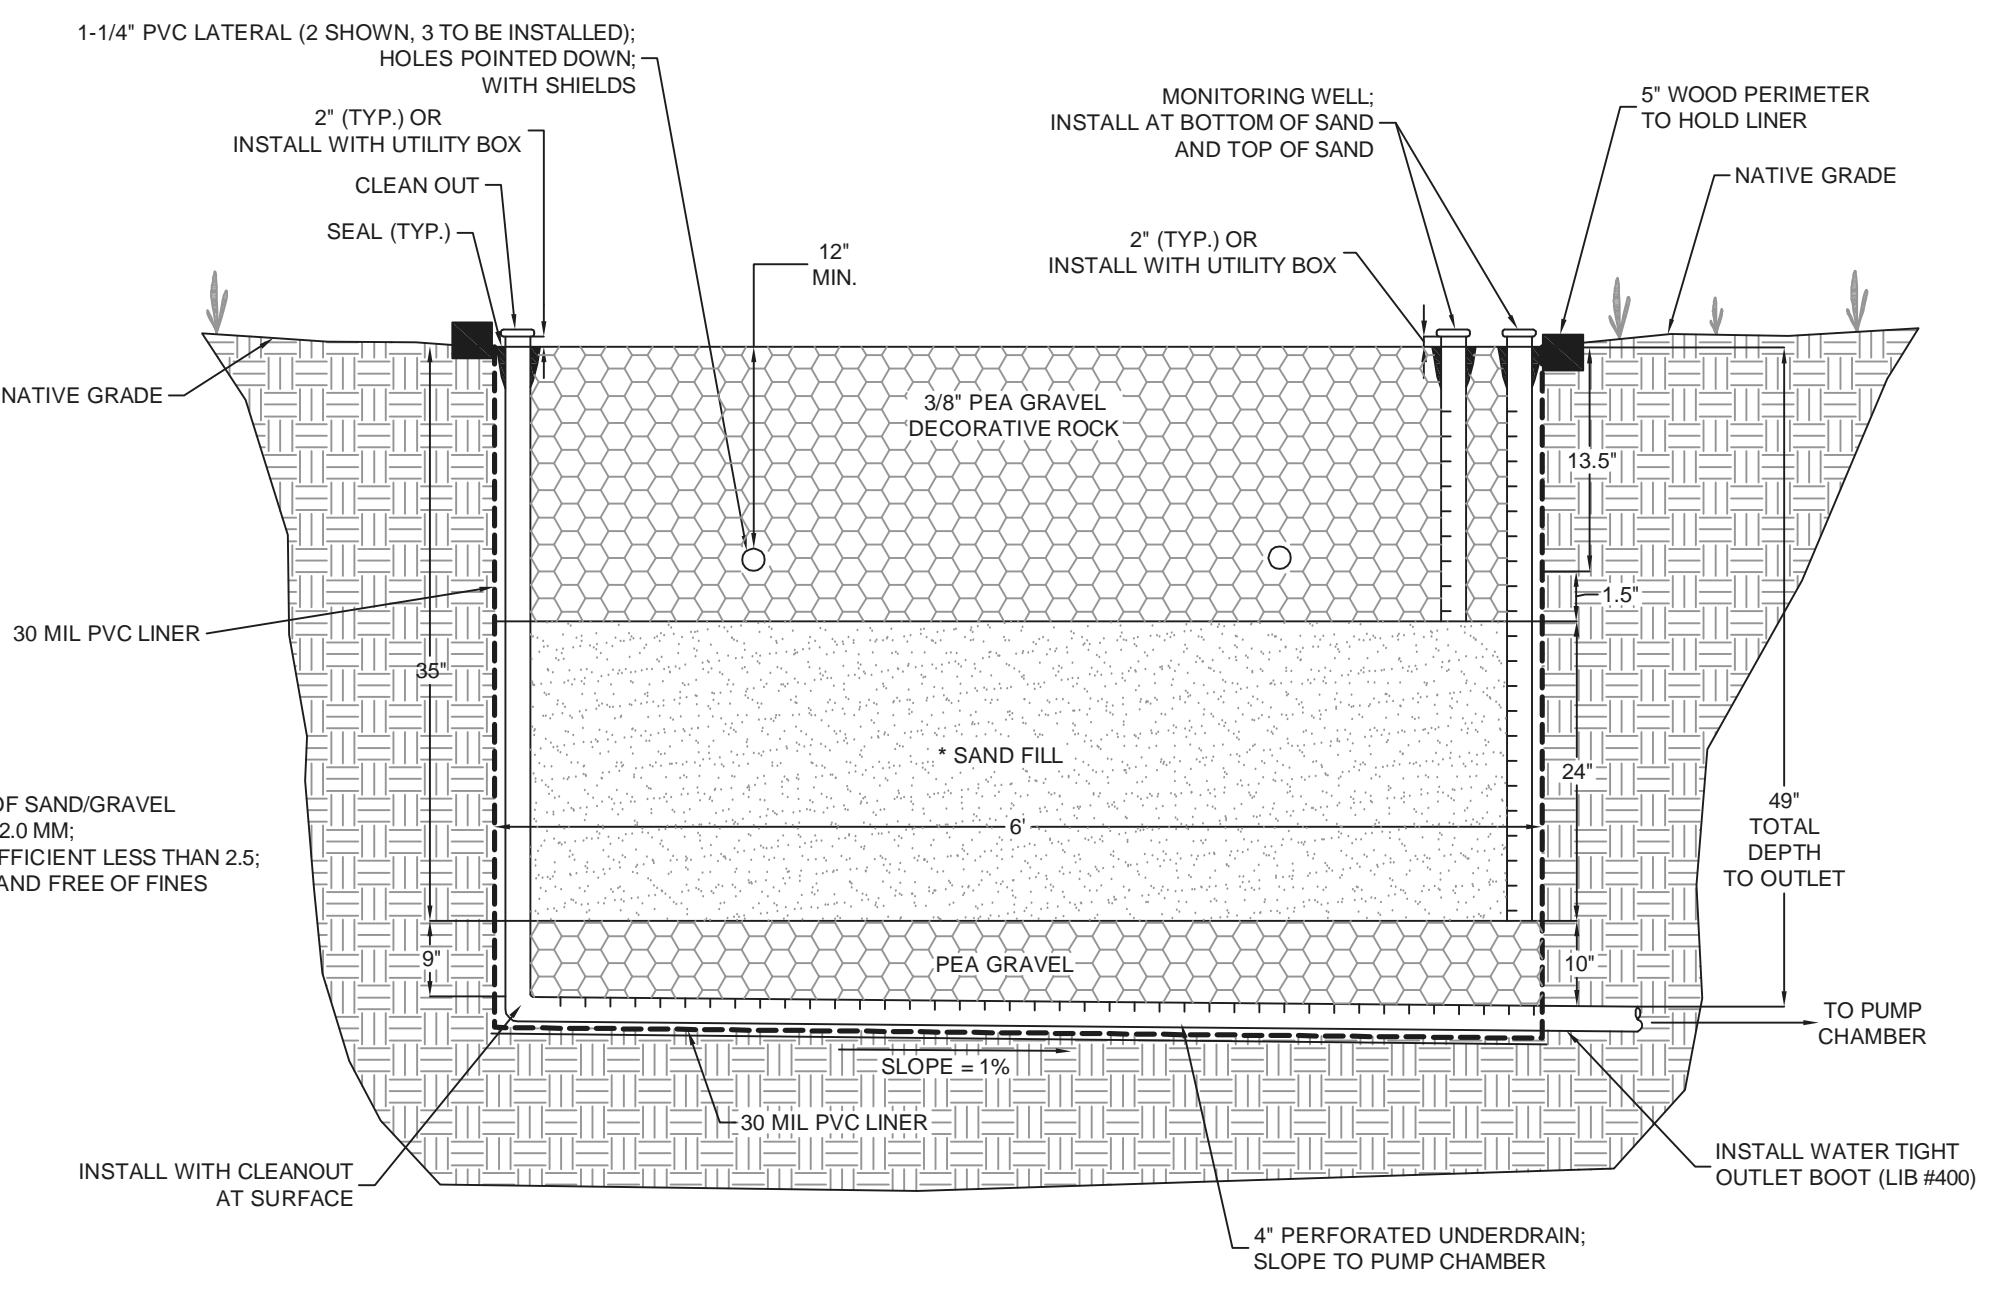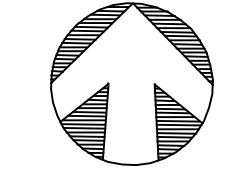

RECIRCULATING SAND FILTER 3

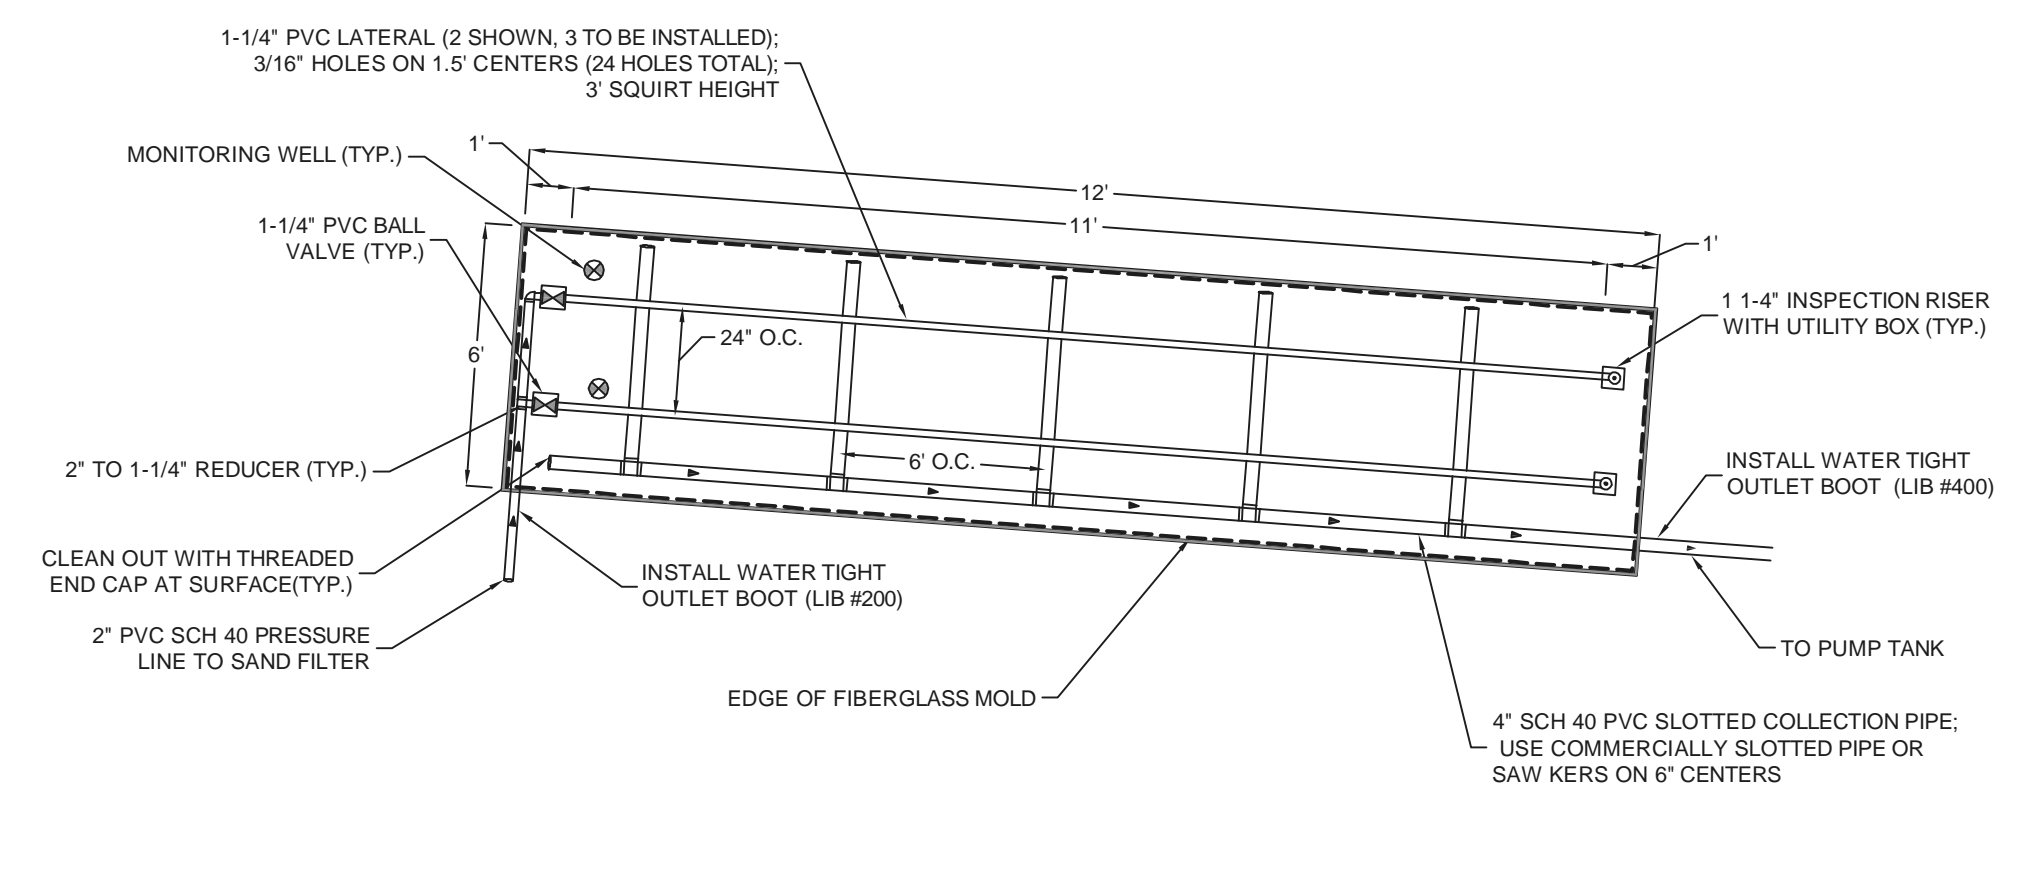

RECIRCULATING SAND FILTER 4

NOTES


* Survey provided by owner from county file

AS-BUILT

APN	157-122-31
DATE / REV.	12 - 25 - 2012 / A
SCALE / SIZE	1" = 8' / ARCHD
SHEET	1 OF 1

MINOR MODIFICATION
TANK TREATMENT SYSTEM

O'SULLIVAN RESIDENCE
50 BAYVIEW
NOVATO, CALIFORNIA

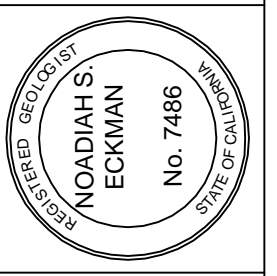

ECKMAN ENVIRONMENTAL CORPORATION

981 STANNAGE
ALBANY, CA 94706
510.390.3992